



APPROVAL TO OPERATE
Contractor Self-Inspection
Onsite Wastewater System

File No.: 2020060014

County: Lancaster


Name: Dylan Ellis
Type Facility: Mobile Home
Subdivision: Bercon Rd.
Block: _____ Lot: _____

Address: 1993 Bercon Rd.
Lancaster, SC
Site: Same

Program Code: 360
Tax Map: _____
Water Supply: Public

ACTUAL INSTALLATION

(NTS)

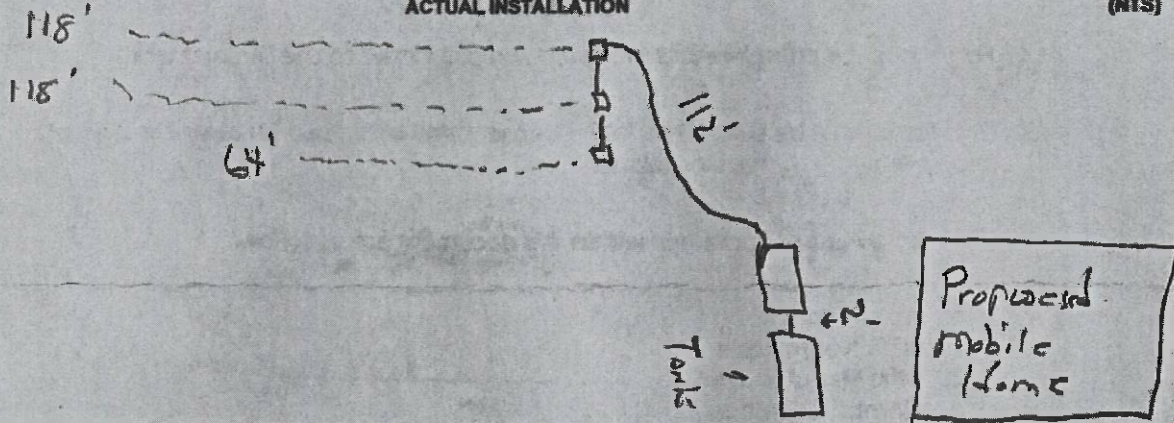

FINAL INSPECTION


Installer: Randy Hudson
Septic Tank Mfr: J+S Size: 1000 (gal)
Pump Chmbr Mfr: J+S Size: 1000 (gal)
Pump Mfr: Goulds
Pump Model: PE 51m
Grease Trap Mfr: _____
Alternative Product: _____
Aggregate Type: Quick 4 Int.
Aggregate Depth (in): _____
Trench Width (in): 36"
Trench Depth (in): 26"
Fill Cap: ☐ Yes ☒ No Fill Cap Depth (in): _____
Well Installed: ☐ Yes ☒ No
Well Dist (ft): _____
Building Dist (ft): _____
Property Dist (ft): 12'
Water Dist (ft): _____

Elevation Readings

Plumbing Stubout: N/A Septic Tank Inlet: 3-2 Septic Tank Outlet: 3-4 1/2 Pump Chmbr Inlet: 3-6

Line No.

Line No.	5-3	5-4 1/2	5-5	5-6
1	5-3	5-4 1/2	5-5	5-6
2	6-2	6-3 1/2	6-4	6-4 1/2
3	7-2	7-3 1/2	7-4	

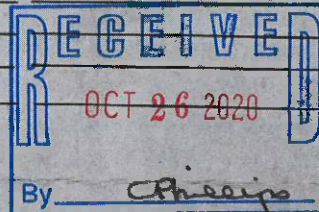

Comments: _____

Contractor Printed Name: Randy Hudson License No.: 29-367-29039

I hereby certify the system was installed in accordance with the referenced permit and R-61-56.

Contractor Signature: Randy Hudson

Date: 10-22-20

Office Use Only:

APPROVAL BY DHEC TO OPERATE
(based on the information provided above)

THIS CERTIFICATE MUST BE COMPLETELY FILLED OUT AND SUBMITTED TO THE LOCAL DHEC REGIONAL OFFICE. THE SYSTEM CANNOT BE PLACED INTO OPERATION UNTIL THIS FORM IS APPROVED AND SIGNED BY A DEPARTMENT REPRESENTATIVE.

Cathy Phillips

10-26-2020